

Date: Thursday, 07/12/2006 9:02:02 AM
 User: Linda Lacelle

Process Sheet

Customer : CU-DAR001 Dart Helicopters Services	Drawing Name : 407 UTILITY BASKET
Job Number : 21174	
Estimate Number : 10920	
P.O. Number : N/A	Part Number : D407663011
This Issue : 07/12/2006 S.O. No. : N/A	Drawing Number : D2955 REV B
Prsht Rev. : NC	Project Number : N/A
First Issue : N/A Type : LARGE FAB ASSY	Drawing Revision : B
Previous Run : 21174	Material : N/A
Written By : _____	Due Date : 05/05/2006 Qty: 1 Um: Each
Checked & Approved By : _____	
Comment : Est Rev:F 05.10.19 Added D2728-3 & AN960JD416L KJ/JLM	

Additional Product

Job Number:



Seq. #:	Machine Or Operation:	Description :
----------------	------------------------------	----------------------

1.0	DC	DOCUMENT CONTROL
-----	----	------------------

**Comment:** DOCUMENT CONTROL

Photocopy bluefile and create labels per PPP D407-663-011CHG002

KS 04.08.09 (1)

2.0	21174A	407 BASKET BASE ASSEMBLY
-----	--------	--------------------------

**Comment:** Sub-Component 407 BASKET BASE ASSEMBLY

D2948-041

3.0	21174B	407 BASKET LID
-----	--------	----------------

**Comment:** Sub-Component 407 BASKET LID

D2952-041

4.0	PACKAGING 1	PACKAGING RESOURCE #1
-----	-------------	-----------------------

**Comment:** PACKAGING RESOURCE #1

Pick Assembly Kit

5.0	D2332041	Lid Prop Assembly 6.69"
-----	----------	-------------------------

**Comment:** Qty.: 1.0000 Each(s)/Unit Total: 1.0000 Each(s)

Pick: Assembly Kit

Qty Part Number Description Batch

1 D2332-041 Prop Ass _____

see attached

Date: Thursday, 07/12/2006 9:02:02 AM

User: Linda Lacelle

Process Sheet

Customer: CU-DAR001 Dart Helicopters Services

Drawing Name: 407 UTILITY BASKET

Job Number: 21174

Part Number: D407663011

Job Number:



Seq. #:

Machine Or Operation:

Description :

6.0

D2530

Handle Weldment



Comment: Qty.: 1.0000 Each(s)/Unit Total : 1.0000 Each(s)

Pick: Assembly Kit

Qty Part Number Description Batch

1 D2530 Handle Weldment

7.0

D2535

Spring



Comment: Qty.: 2.0000 Each(s)/Unit Total : 2.0000 Each(s)

Pick: Assembly Kit

Qty Part Number Description Batch

2 D2535 Spring

8.0

D2537

Bushing



Comment: Qty.: 2.0000 Each(s)/Unit Total : 2.0000 Each(s)

Pick: Assembly Kit

Qty Part Number Description Batch

2 D2537 Bushing

9.0

D27283

Dart Logo label large



Comment: Qty.: 2.0000 Each(s)/Unit Total : 2.0000 Each(s)

Pick: Assembly Kit

Qty Part Number Description Batch

2 D2728-3 Label

10.0

D2851145

Placard



Comment: Qty.: 1.0000 Each(s)/Unit Total : 1.0000 Each(s)

Pick: Assembly Kit

Qty Part Number Description Batch

1 d2851-145 Placard

11.0

D2931

Bumper



Comment: Qty.: 2.0000 Each(s)/Unit Total : 2.0000 Each(s)

Pick: Assembly Kit

Qty Part Number Description Batch

2 D2931 Bumper

Date: Thursday, 07/12/2006 9:02:03 AM
User: Linda Lacelle

Process Sheet

Customer: CU-DAR001 Dart Helicopters Services

Drawing Name: 407 UTILITY BASKET

Job Number: 21174

Part Number: D407663011

Job Number:



Seq. #:

Machine Or Operation:

Description :

12.0

D2961

Label



Comment: Qty.: 1.0000 Each(s)/Unit Total : 1.0000 Each(s)

Pick: Assembly Kit

Qty Part Number Description Batch

1 D22961 Label _____

13.0

AN320A

Bolt



Comment: Qty.: 2.0000 Each(s)/Unit Total : 2.0000 Each(s)

Pick: Assembly Kit

Qty Part Number Description Batch

2 AN3-20A Bolt _____

14.0

AN414A

Bolt



Comment: Qty.: 2.0000 Each(s)/Unit Total : 2.0000 Each(s)

Pick: Assembly Kit

Qty Part Number Description Batch

2 AN4-14A Bolt _____

15.0

AN422A

Bolt



Comment: Qty.: 2.0000 Each(s)/Unit Total : 2.0000 Each(s)

Pick: Assembly Kit

Qty Part Number Description Batch

2 AN4-22A Bolt _____

16.0

AN517A

Bolt



Comment: Qty.: 2.0000 Each(s)/Unit Total : 2.0000 Each(s)

Pick: Assembly Kit

Qty Part Number Description Batch

2 AN5-17A Bolt _____

Date: Thursday, 07/12/2006 9:02:03 AM
User: Linda Lacelle

Process Sheet

Customer: CU-DAR001 Dart Helicopters Services

Drawing Name: 407 UTILITY BASKET

Job Number: 21174

Part Number: D407663011

Job Number:



Seq. #:

Machine Or Operation:

Description :

17.0

AN521A

Bolt



Comment: Qty.: 2.0000 Each(s)/Unit Total : 2.0000 Each(s)

Pick: Assembly Kit

Qty Part Number Description Batch

2 AN5-21A Bolt

18.0

AN960JD416

Washer



Comment: Qty.: 4.0000 Each(s)/Unit Total : 4.0000 Each(s)

Pick: Assembly Kit

Qty Part Number Description Batch

4 AN960JD416 Washer

19.0

AN960JD416L

Washer



Comment: Qty.: 2.0000 Each(s)/Unit Total : 2.0000 Each(s)

Pick: Assembly Kit

Qty Part Number Description Batch

2 AN960JD416L Washer

20.0

AN960JD516

Washer



Comment: Qty.: 4.0000 Each(s)/Unit Total : 4.0000 Each(s)

Pick: Assembly Kit

Qty Part Number Description Batch

4 AN960JD516 Washer

21.0

AN960JD8

Washer



Comment: Qty.: 2.0000 Each(s)/Unit Total : 2.0000 Each(s)

Pick: Assembly Kit

Qty Part Number Description Batch

2 AN960JD8 Washer

Date: Thursday, 07/12/2006 9:02:03 AM
User: Linda Lacelle

Process Sheet

Customer: CU-DAR001 Dart Helicopters Services

Drawing Name: 407 UTILITY BASKET

Job Number: 21174

Part Number: D407663011

Job Number:



Seq. #:

Machine Or Operation:

Description :

22.0

AN9704

Washer



Comment: Qty.: 4.0000 Each(s)/Unit Total : 4.0000 Each(s)

Pick: Assembly Kit

Qty Part Number Description Batch

4 AN970-4 Washer

23.0

MS20600AD4W3

Cherry Rivets



Comment: Qty.: 2.0000 Each(s)/Unit Total : 2.0000 Each(s)

Pick: Assembly Kit

Qty Part Number Description Batch

2 MS20600AD4W3 Rivet

24.0

MS21042L3

Nut



Comment: Qty.: 2.0000 Each(s)/Unit Total : 2.0000 Each(s)

Pick: Assembly Kit

Qty Part Number Description Batch

2 MS21042L3 Nut (or -3)

25.0

MS21042L4

Nut



Comment: Qty.: 4.0000 Each(s)/Unit Total : 4.0000 Each(s)

Pick: Assembly Kit

Qty Part Number Description Batch

4 MS21042L4 Nut (or -4)

26.0

MS21042L5

Nut



Comment: Qty.: 4.0000 Each(s)/Unit Total : 4.0000 Each(s)

Pick: Assembly Kit

Qty Part Number Description Batch

4 MS21042L5 Nut (or -5)

Date: Thursday, 07/12/2006 9:02:03 AM
User: Linda Lacelle

Process Sheet

Customer: CU-DAR001 Dart Helicopters Services

Drawing Name: 407 UTILITY BASKET

Job Number: 21174

Part Number: D407663011

Job Number:



Seq. #:

Machine Or Operation:

Description :

27.0

SMALL FAB 1

SMALL & MEDIUM FAB RESOURCE 1



sel 7 Hader



Comment: SMALL & MEDIUM FAB RESOURCE 1

Assemble basket as per Dwg D2955. Inspect for foreign objects as per QSI 024.

28.0

QC5

INSPECT WORK TO CURRENT STEP



Comment: INSPECT WORK TO CURRENT STEP

29.0

PACKAGING 1

PACKAGING RESOURCE #1



Comment: PACKAGING RESOURCE #1

Pick Packing Kit

30.0

D2852

Label



Comment: Qty.: 1.0000 Each(s)/Unit Total : 1.0000 Each(s)

Pick: Packing Kit

✓ Qty Part Number Description Batch
1 D2852 Label B25124

31.0

D2984

Label



Comment: Qty.: 1.0000 Each(s)/Unit Total : 1.0000 Each(s)

Pick: Packing Kit

✓ Qty Part Number Description Batch
1 D2984 Label B12605

32.0

D407301011

Center Bracket Kit



Comment: Qty.: 1.0000 Each(s)/Unit Total : 1.0000 Each(s)

Pick: Packing Kit

✓ Qty Part Number Description Batch
1 D407-301-011 Center Bracket Kit B21171

33.0

D407302011

Outboard Bracket Kit



Comment: Qty.: 1.0000 Each(s)/Unit Total : 1.0000 Each(s)

Pick: Packing Kit

✓ Qty Part Number Description Batch
1 D407-302-011 Outboard Bracket Kit B22091

Date: Thursday, 07/12/2006 9:02:03 AM
User: Linda Lacelle

Process Sheet

Customer: CU-DAR001 Dart Helicopters Services

Drawing Name: 407 UTILITY BASKET

Job Number: 21174

Part Number: D407663011

Job Number:



Seq. #:

Machine Or Operation:

Description :

34.0

AN311A

Bolt



Comment: Qty.: 6.0000 Each(s)/Unit Total: 6.0000 Each(s)

Pick: Packing Kit

Qty Part Number Description Batch

✓ 8 AN3-11A Bolt M4067

35.0

AN960JD10

Washer



Comment: Qty.: 6.0000 Each(s)/Unit Total: 6.0000 Each(s)

Pick: Packing Kit

Qty Part Number Description Batch

✓ 6 AN960JD10 Washer M100743

36.0

MS21042L3

Nut



Comment: Qty.: 6.0000 Each(s)/Unit Total: 6.0000 Each(s)

Pick: Packing Kit

Qty Part Number Description Batch

✓ 6 MS21042L3 Nut (or -3) M101917

U 6/12/07

37.0

QC4

INSPECT 100% KITS FOR COMPLETENESS



Comment: INSPECT 100% KITS FOR COMPLETENESS

U 06/12/07

38.0

PACKAGING 1

PACKAGING RESOURCE #1



Comment: PACKAGING RESOURCE #1

Identify and pack for shipping as per PPP D407-663-011

Location: _____

PPP Rev: C

U 6/12/07 (1)

39.0

DC

DOCUMENT CONTROL



Comment: DOCUMENT CONTROL

Inspection Level 21

U 06/12/07 (1)

Job Completion



U 06.12.07

75/35

DART AEROSPACE LTD	Work Order:	21174
Description: 407 Utility Basket	Part Number:	D407-663-011
Dwg: D2955 Rev. B	Qty:	1
Ref: ICA-D407-663 Rev. 0 page 27		Page 1 of 2

Step	Location	Procedure	By	Date	Qty	
1	DC	Issue Travelers for: D407-663-011 407 Utility Basket <u>Batch 21174</u> D2948-041 407 Basket Base <u>21174</u> D2952-041 407 Basket Lid <u>21174</u>	JK	05.10.19	1	
2	DC	Photocopy bluefile and create labels per PPP D407-663-011 CHG002	
3	FP	Powder Coat Gloss White (Ref: 4.3.5.2) D2948-041 Base and Powder Coat Gloss White (Ref: 4.3.5.1) D2952-041 Lid as per QSI 005 4.3.	N/A	
4	QC3	Inspect Powder Coat	
5	GA	Assemble basket as per Dwg D2955. Inspect for foreign objects as per QSI 024. Pick: <table border="1"> <thead> <tr> <th>Qty</th> <th>Part Number</th> <th>Description</th> <th>Batch</th> </tr> </thead> <tbody> <tr><td>1</td><td>D2332-041</td><td>Prop Assembly</td><td>B 28246</td></tr> <tr><td>1</td><td>D2530</td><td>Handle Weldment</td><td>B 28997</td></tr> <tr><td>2</td><td>D2535</td><td>Spring</td><td>B 25087</td></tr> <tr><td>2</td><td>D2537</td><td>Bushing</td><td>B 29536</td></tr> <tr><td>2</td><td>D2728-3</td><td>Label</td><td>B 22553</td></tr> <tr><td>1</td><td>D2851-145</td><td>Placard</td><td>B 21197</td></tr> <tr><td>2</td><td>D2931</td><td>Bumper</td><td>B 21139</td></tr> <tr><td>1</td><td>D2961</td><td>Placard</td><td>B 12077</td></tr> <tr><td>2</td><td>AN3-20A</td><td>Bolt</td><td>M 15432</td></tr> <tr><td>2</td><td>AN4-14A</td><td>Bolt</td><td>M 100188</td></tr> <tr><td>2</td><td>AN4-22A</td><td>Bolt</td><td>M 17280</td></tr> <tr><td>2</td><td>AN5-17A</td><td>Bolt</td><td>M 102140</td></tr> <tr><td>2</td><td>AN5-21A</td><td>Bolt</td><td>M 1053821</td></tr> <tr><td>4</td><td>AN960JD416</td><td>Washer</td><td>M 6085</td></tr> <tr><td>2</td><td>AN960JD416L</td><td>Washer</td><td>M 101237</td></tr> <tr><td>4</td><td>AN960JD516</td><td>Washer</td><td>M 100564</td></tr> <tr><td>2</td><td>AN960JD8</td><td>Washer</td><td>M 102455</td></tr> <tr><td>4</td><td>AN970-4</td><td>Washer x1 - m 106151 - 3x m 102380</td><td></td></tr> <tr><td>2</td><td>MS20600AD4W3</td><td>Rivet</td><td>M 14393</td></tr> <tr><td>2</td><td>MS21042L3</td><td>Nut (or -3)</td><td>M 101917</td></tr> <tr><td>4</td><td>MS21042L4</td><td>Nut (or -4)</td><td>M 19185</td></tr> <tr><td>4</td><td>MS21042L5</td><td>Nut (or -5)</td><td>M 102171</td></tr> </tbody> </table> Identify as D2955-041	Qty	Part Number	Description	Batch	1	D2332-041	Prop Assembly	B 28246	1	D2530	Handle Weldment	B 28997	2	D2535	Spring	B 25087	2	D2537	Bushing	B 29536	2	D2728-3	Label	B 22553	1	D2851-145	Placard	B 21197	2	D2931	Bumper	B 21139	1	D2961	Placard	B 12077	2	AN3-20A	Bolt	M 15432	2	AN4-14A	Bolt	M 100188	2	AN4-22A	Bolt	M 17280	2	AN5-17A	Bolt	M 102140	2	AN5-21A	Bolt	M 1053821	4	AN960JD416	Washer	M 6085	2	AN960JD416L	Washer	M 101237	4	AN960JD516	Washer	M 100564	2	AN960JD8	Washer	M 102455	4	AN970-4	Washer x1 - m 106151 - 3x m 102380		2	MS20600AD4W3	Rivet	M 14393	2	MS21042L3	Nut (or -3)	M 101917	4	MS21042L4	Nut (or -4)	M 19185	4	MS21042L5	Nut (or -5)	M 102171	ml	06/12/06	1
Qty	Part Number	Description	Batch	
1	D2332-041	Prop Assembly	B 28246	
1	D2530	Handle Weldment	B 28997	
2	D2535	Spring	B 25087	
2	D2537	Bushing	B 29536	
2	D2728-3	Label	B 22553	
1	D2851-145	Placard	B 21197	
2	D2931	Bumper	B 21139	
1	D2961	Placard	B 12077	
2	AN3-20A	Bolt	M 15432	
2	AN4-14A	Bolt	M 100188	
2	AN4-22A	Bolt	M 17280	
2	AN5-17A	Bolt	M 102140	
2	AN5-21A	Bolt	M 1053821	
4	AN960JD416	Washer	M 6085	
2	AN960JD416L	Washer	M 101237	
4	AN960JD516	Washer	M 100564	
2	AN960JD8	Washer	M 102455	
4	AN970-4	Washer x1 - m 106151 - 3x m 102380	
2	MS20600AD4W3	Rivet	M 14393	
2	MS21042L3	Nut (or -3)	M 101917	
4	MS21042L4	Nut (or -4)	M 19185	
4	MS21042L5	Nut (or -5)	M 102171	
6	QC5	Inspect work to Step 5		06.12.06	1	

RELEASED
11/05/10

W/O:		WORK ORDER CHANGES					
DATE	STEP	PROCEDURE CHANGE	By	Date	Qty	Approval Mfg / Design Mgr	Approval QC Inspector

NCR:		WORK ORDER NON-CONFORMANCE (NCR)						
DATE	STEP	Description of NC Section A	Corrective Action Section B			Verification Section C	Approval Design Mgr	Approval QC Inspector
			Initial Design Mgr	Action Description Design Mgr	Sign & Date			

Part No: _____ PAR #: _____ Fault Category: _____ NCR: Yes No DQA: _____ Date: _____

NOTE: Date & initial all entries

QA: N/C Closed: _____ Date: _____

DART AEROSPACE LTD	Work Order:	21174
Description: 407 Utility Basket	Part Number:	D407-663-011
Dwg: D2955 Rev. B	Qty:	1
Ref: ICA-D407-663 Rev. 0 page 27		Page 2 of 2

Step	Location	Procedure	By	Date	Qty																																				
7	KP	Pick: Packing Kit (Note: D2955-041 is on BOM as parts listed in Step 5). <table border="1"> <thead> <tr> <th>Qty</th> <th>Part Number</th> <th>Description</th> <th>Batch</th> </tr> </thead> <tbody> <tr> <td>✓ 1</td> <td>D2852</td> <td>Label</td> <td>B25124</td> </tr> <tr> <td>✓ 1</td> <td>D2955-041</td> <td>Basket Assembly</td> <td>B21174B</td> </tr> <tr> <td>✓ 1</td> <td>D2984</td> <td>Label</td> <td>B12605</td> </tr> <tr> <td>✓ 1</td> <td>D407-301-011</td> <td>Center Bracket Kit</td> <td>B21177</td> </tr> <tr> <td>✓ 1</td> <td>D407-302-011</td> <td>Outboard Bracket Kit</td> <td>B22090</td> </tr> <tr> <td>✓ 6</td> <td>AN3-11A</td> <td>Bolt</td> <td>M14069</td> </tr> <tr> <td>✓ 6</td> <td>AN960JD10</td> <td>Washer</td> <td>M150743</td> </tr> <tr> <td>✓ 6</td> <td>MS21042L3</td> <td>Nut (or -3)</td> <td>M101917</td> </tr> </tbody> </table>	Qty	Part Number	Description	Batch	✓ 1	D2852	Label	B25124	✓ 1	D2955-041	Basket Assembly	B21174B	✓ 1	D2984	Label	B12605	✓ 1	D407-301-011	Center Bracket Kit	B21177	✓ 1	D407-302-011	Outboard Bracket Kit	B22090	✓ 6	AN3-11A	Bolt	M14069	✓ 6	AN960JD10	Washer	M150743	✓ 6	MS21042L3	Nut (or -3)	M101917			
Qty	Part Number	Description	Batch																																						
✓ 1	D2852	Label	B25124																																						
✓ 1	D2955-041	Basket Assembly	B21174B																																						
✓ 1	D2984	Label	B12605																																						
✓ 1	D407-301-011	Center Bracket Kit	B21177																																						
✓ 1	D407-302-011	Outboard Bracket Kit	B22090																																						
✓ 6	AN3-11A	Bolt	M14069																																						
✓ 6	AN960JD10	Washer	M150743																																						
✓ 6	MS21042L3	Nut (or -3)	M101917																																						
8	QC4	Inspect Kit 100% for Completeness on the W/O																																							
9	PK	Identify and pack for shipping as per PPP D407-663-011																																							
10	AC	Cost / part: _____																																							
11	DC	Close W/Order and Ensure Travellers Attached Inspect Level 21 Travellers: D407-663-011 D2948-041 D2952-041																																							

Rev	Date	Change	Revised By	Approved
A	00.03.23	New Issue	EC	
B	00.07.06	Added K10001	EC	
C	00.08.10	Added D2984 (mpp 2080)	EC	
D	01.03.08	Changed pick list (mpp 2119)	EC	
E	03.11.26	Reformat; Incorporated D2955-041	KJ/RF	
F	05.10.19	Added D2728-3 & AN960JD416L	KJ/JLM	

RELEASED
 11/5/19

W/O:		WORK ORDER CHANGES					
DATE	STEP	PROCEDURE CHANGE	By	Date	Qty	Approval Mfg / Design Mgr	Approval QC Inspector

NCR:		WORK ORDER NON-CONFORMANCE (NCR)						
DATE	STEP	Description of NC Section A	Corrective Action Section B			Verification Section C	Approval Design Mgr	Approval QC Inspector
			Initial Design Mgr	Action Description Design Mgr	Sign & Date			

Part No: _____ PAR #: _____ Fault Category: _____ NCR: Yes ☐ No ☒ DQA: HP Date: 04/12/07

NOTE: Date & initial all entries

QA: N/C Closed: _____ Date: _____



DESIGN RF	DRAWN BY RF	DART AEROSPACE LTD HAWKESBURY, ONTARIO, CANADA	
CHECKED #	APPROVED #	DRAWING NO. D2955	REV. B SHEET 1 OF 2
DATE 00.07.17		TITLE BASKET ASSEMBLY	SCALE NTS
A	00.01.13	NEW ISSUE	
B	00.07.17	UPDATE TOP VIEW OF BASKET	

Qty -041	Part Number	Description
X	D2955-041	BASKET ASSEMBLY
1	D2332-041	LID PROP ASSEMBLY
1	D2530	HANDLE WELDMENT
2	D2535	SPRING
2	D2537	BUSHING
1	D2851-145	PLACARD
1	D2961	PLACARD
2 A	D2931	BUMPER
1	D2948-041	BASKET BASE ASSEMBLY
1	D2952-041	BASKET LID ASSEMBLY
2	AN3-20A	BOLT
2	AN4-14A	BOLT
2	AN4-22A	BOLT
2	AN5-17A	BOLT
2	AN5-21A	BOLT
6	AN960JD416	WASHER
4	AN960JD516	WASHER
2 A	AN960JD8	WASHER
4	AN970-4	WASHER
2 A	MS20600AD4W3	RIVET
2	MS21042L3	NUT (OR MS21042-3)
4	MS21042L4	NUT (OR MS21042-4)
4	MS21042L5	NUT (OR MS21042-5)

#00.09.08
RF

#00.09.08
RF

#00.09.08
RF

SHOP COPY
RETURN TO
ENGINEERING

UNCONTROLLED COPY
SUBJECT TO AMENDMENT
WITHOUT NOTICE

WORK ORDER
NO. 21174

RELEASED
00.07.18 #

Copyright © 2000 by DART AEROSPACE LTD

THIS DOCUMENT IS PRIVATE AND CONFIDENTIAL AND IS SUPPLIED ON THE EXPRESS CONDITION THAT IT IS NOT TO BE USED FOR ANY PURPOSE OR COPIED OR COMMUNICATED TO ANY OTHER PERSON WITHOUT WRITTEN PERMISSION FROM DART AEROSPACE LTD.

D2952-041 BASKET
LID ASSEMBLY

D2851-145 PLACARD (1)
D2961 PLACARD (1)

D2948-041 BASKET
BASE ASSEMBLY

PROP AR

AN4-1
AN960
MS210
(2 PL)

D2535 SPRING (1)
D2537 BUSHING (1)
(2 PLACES)

SHOP COPY
RETURN TO
ENGINEERING
UNCONTROLLED COPY
SUBJECT TO AMENDMENT
WITHOUT NOTICE

WORK ORDER

21174
RELEASED
00.07.18

DETAIL C
SPRING DETAIL

DETAIL A
HINGE DETAIL

DRAWN BY

RF

APPROVED

#

DART

DART AEROSPACE LTD.
HAWKESBURY, ONTARIO, CANADA

DRAWING NO.

D2955

REV. B

SHEET 2 OF 2

TITLE

BASKET ASSEMBLY

SCALE

NTS

Job Costing Report

Dart Aerospace Ltd.
Hawkesbury

Jul 01, 2004
02:00 pm

Work Order No : 0021174
Project Name : D407-663-011
Project For : WK435
Work Order Type : Main
Main WO Number :
House Part Number : *D407-663-011
Description : Heli-Utility-Basket
Manufactured : Yes
Amount Req'd : 1
Amount Done : 0
Start Date : 07-01-04
Est Finish Date : 08-26-04
Act Finish Date :
Drawings Req'd : No
Ok for Approval :
Approval Rec'd :

Department Code:
Burden Flags : NNNNNNN
WO Status : Open
Invoice State : Not Invoiced
Invoice Date :
Invoice Number :
Invoice Amount : 0.00
Order Entry No :
OE Value : 0.00
Est Margin : 0.000%
Actual Margin : 0.000%
\$0 Posted to Finished Goods

	Estimated	Actual	Var. %	Posted	To Post
Material Cost :	0.00	0.00	0.00	0.00	0.00
Engineering Hours :	0.00	0.00	0.00		
Engineering Cost :	0.00	0.00	0.00	0.00	0.00
Production Hours :	0.00	0.00	0.00		
Production Cost :	0.00	0.00	0.00	0.00	0.00
Packaging Hours :	0.00	0.00	0.00		
Packaging Cost :	0.00	0.00	0.00	0.00	0.00
OverHead Hours :	0.00	0.00	0.00		
OverHead Cost :	0.00	0.00	0.00	0.00	0.00
CNC Hours :	0.00	0.00	0.00		
CNC :	0.00	0.00	0.00	0.00	0.00
Misc. Hours :	0.00	0.00	0.00		
Misc. :	0.00	0.00	0.00	0.00	0.00
Burden :	0.00	0.00	0.00		
Total Cost :	0.00	0.00	0.00		
Margin :	0.000	0.000			
Selling Cost :	0.00	0.00			

	Estimated	Actual
Labour Hrs/Amount Done :	0.00	0.00
Profits/(Loss) :	0.00	0.00

Date: Thursday, 11/24/2005 8:10:14 AM
 User: Linda Lacelle

Process Sheet

Customer : CU-DAR001 Dart Helicopters Services	Drawing Name : 407 BASKET LID
Job Number : 21174B	
Estimate Number : 10917	
P.O. Number : <i>N/A</i>	Part Number : D2952041
This Issue : 11/24/2005 S.O. No. : <i>N/A</i>	Drawing Number : D2952 REV B
Prsht Rev. : NC	Project Number : N/A
First Issue : <i>N/A</i> Type : LARGE FAB ASSY	Drawing Revision : B
Previous Run : <i>N/A</i>	Material : <i>N/A</i>
Written By : <i>[Signature]</i>	Due Date : 1/30/2006 Qty: 1 Um: Each
Checked & Approved By : _____	
Comment : Est Rev:C 03.11.26 Reformat KJ/RF	

Additional Product

Job Number:



Seq. #:	Machine Or Operation:	Description :
----------------	------------------------------	----------------------

1.0	M6061T6TS0750W062	6061-T6 SQ Tube.75x.062W
-----	-------------------	--------------------------



Comment: Qty.: 39.3750 f(s)/Unit Total : 39.3750 f(s)
 Material: 6061-T6 (QQ-A-200/8 or QQ-A-225/8) 0.062" wall
 (M6061T6TS0.750W.062)
 Batch: *M16441*

PD 06-11-14 ①

2.0	M5052H32S080	5052-H32 .080 Sheet
-----	--------------	---------------------



Comment: Qty.: 0.0656 sf(s)/Unit Total : 0.0656 sf(s)
6061-T6 Material: 5052-H32/H34 (QQ-A-250/11 or QQ-A-250/8) 0.080"
 (M5052H32S.080) (*M6061T6S 0.80*)
 Batch: *M102448*
 Identify as D2952-11

PD 06-11-14 ①

3.0	D2953077	Spacer
-----	----------	--------



Comment: Qty.: 2.0000 Each(s)/Unit Total : 2.0000 Each(s)
 Pick:
 Qty Part Number Description Batch
 2 D2953-077 Spacer *B13267* → 1 *B22095* → 1

PD 06-11-14 ①

4.0	D2953175	Spacer
-----	----------	--------



Comment: Qty.: 1.0000 Each(s)/Unit Total : 1.0000 Each(s)
 Pick:
 Qty Part Number Description Batch
 1 D2953-175 Spacer *B22096*

PD 06-11-14 ①

Date: Thursday, 11/24/2005 8:10:15 AM
User: Linda Lacelle

Process Sheet

Customer: CU-DAR001 Dart Helicopters Services

Drawing Name: 407 BASKET LID

Job Number: 21174B

Part Number: D2952041

Job Number:



Seq. #: Machine Or Operation: Description :

5.0 D2957 Mounting Plate



Comment: Qty.: 6.0000 Each(s)/Unit Total : 6.0000 Each(s)

Pick:

Qty Part Number Description Batch
6 D2957 Mounting Plate B21198

PD 06-11-14 (1)

6.0 M1100H14ES34X051F Alum Expanded Metal



Comment: Qty.: 15.7500 sf(s)/Unit Total : 15.7500 sf(s)

Pick:

Qty Part Number Description Batch
15sf M1100H14ES-3/4x.051F Mesh M17390

PD 06-11-14 (1)

7.0 LARGE FAB 1 LARGE FABRICATION RESOURCE 1



Comment: LARGE FABRICATION RESOURCE 1

1-Cut D2952-11 corner gussets as per Dwg D2952

2-Drill holes in D2952-3 as per Dwg D2952.

3- Deburr & Remove any Markings From Material

4-Weld as per Dwg D2952 as per QSI 004. Deburr as required

A/R AL ROD Batch: M100237

PD 06-11-14 (1)

8.0 QC9/6 DDIMENSIONAL & WELDING INSPECTION



Comment: DDIMENSIONAL & WELDING INSPECTION

106/11/14 (2)

9.0 HAND FINISHING1 HAND FINISHING RESOURCE #1



Comment: HAND FINISHING RESOURCE #1

Chemical Conversion Coat as per QSI 005 4.1

yl 06/11/13 X1

10.0 D2983 Label Plate



Comment: Qty.: 1.0000 Each(s)/Unit Total : 1.0000 Each(s)

Label Plate B13268

PD 06-11-14 (1)

Date: Thursday, 11/24/2005 8:10:15 AM
User: Linda Lacelle

Process Sheet

Customer: CU-DAR001 Dart Helicopters Services

Drawing Name: 407 BASKET LID

Job Number: 21174B

Part Number: D2952041

Job Number:



Seq. #:

Machine Or Operation:

Description :

11.0

MS20600AD4W2

Rivet



Comment: Qty.: 34.0000 Each(s)/Unit Total: 34.0000 Each(s)

Rivet

M4747

PD 06-11-15 (1)

12.0

LARGE FAB 1

LARGE FABRICATION RESOURCE 1



Comment: LARGE FABRICATION RESOURCE 1

1-Assemble Label Plate as per Dwg D2952

PD 06-11-15 (1)

13.0

POWDER COATING

POWDER COATING



Comment: POWDER COATING

Powder Coat White Gloss (Ref: 4.3.5.1) as per QSI 005 4.3

FC 06 12 05 (1)

14.0

QC3

INSPECT POWDER COAT/CHEMICAL CONVERSION



Comment: INSPECT POWDER COAT/CHEMICAL CONVERSION

m 06/12/06

15.0

PACKAGING 1

PACKAGING RESOURCE #1



Comment: PACKAGING RESOURCE #1

Identify and Stock

Location: GA

m 06/12/06

16.0

DC

DOCUMENT CONTROL



Comment: DOCUMENT CONTROL

Inspection Level 21

06/12/07 (1)

Job Completion



→ 12.1

QC 5 inspection

M 06/11/16 (1)

(permanent change)

Date: Thursday, 11/24/2005 8:09:58 AM
 User: Linda Lacelle

Process Sheet

Customer :	CU-DAR001 Dart Helicopters Services	Drawing Name :	407 BASKET BASE ASSEMBLY
Job Number :	21174A		
Estimate Number :	10912		
P.O. Number :	N/A	Part Number :	D2948041
This Issue :	11/24/2005	S.O. No. :	N/A
Prsht Rev. :	NC	Drawing Number :	D2948 REV B
First Issue :	N/A	Project Number :	N/A
Previous Run :	N/A	Drawing Revision :	B
	Type :	Material :	N/A
	LARGE FAB ASSY	Due Date :	1/30/2006
Written By :		Qty:	1 Um: Each
Checked & Approved By :			
Comment :	Est Rev:E 04.08.09 Revised Step 1 KJJ/JLM		

Additional Product

Job Number:



Seq. #:	Machine Or Operation:	Description :
1.0	M304TS0750W049	304 RD Tube .750 x .049W
Comment: Qty.: 48.9993 f(s)/Unit Total: 48.9993 f(s) Material: 304/316 SS tube 0.049" wall M15256-310' (M304TS0.750W.049) M12476-310' Batch: M19161-17.08' M15357-3.92'		
2.0	LANDING GEAR 1	LANDING GEAR RESOURCE 1
Comment: LANDING GEAR RESOURCE 1 Cut (2) D2948-5, 3/4" x 3/4" 120" square tubing for bending as per Dwg D2948		
3.0	BENDING	BENDING MACHINE
Comment: BENDING MACHINE Form D2948-5 as per Dwg D2948 using CNC bending program 407BASB and Folio FT019		
4.0	QC5	INSPECT WORK TO CURRENT STEP
Comment: INSPECT WORK TO CURRENT STEP		
5.0	D23273	Spacer Bushing
Comment: Qty.: 1.0000 Each(s)/Unit Total: 1.0000 Each(s) Pick: Qty Part Number Description Batch 1 D2327-3 Spacer 528073		

Date: Thursday, 11/24/2005 8:09:58 AM
User: Linda Lacelle

Process Sheet

Customer: CU-DAR001 Dart Helicopters Services

Drawing Name: 407 BASKET BASE ASS

Job Number: 21174A

Part Number: D2948041

Job Number:



Seq. #:	Machine Or Operation:	Description:
---------	-----------------------	--------------

6.0	D2581	Mounting Bracket
-----	-------	------------------



Comment: Qty.: 2.0000 Each(s)/Unit Total: 2.0000 Each(s)

Pick:

Qty	Part Number	Description
2	D2581	Mounting Bracket

Batch:

021881

PD 06-11-15 (1)

7.0	D2954	Mounting Plate
-----	-------	----------------



Comment: Qty.: 4.0000 Each(s)/Unit Total: 4.0000 Each(s)

Pick:

Qty	Part Number	Description
4	D2954	Mounting Plate

Batch:

012525

PD 06-11-15 (1)

8.0	M304EX07516F	Expanded Metal Flat Stai
-----	--------------	--------------------------



Comment: Qty.: 33.6000 sf(s)/Unit Total: 33.6000 sf(s)

Pick:

Qty	Part Number	Description	Batch
32sf	M304EX0.75-16F	SS Expanded Metal	M102394

M102394

PD 06-11-15 (1)

9.0	LARGE FAB 1	LARGE FABRICATION RESOURCE 1
-----	-------------	------------------------------



Comment: LARGE FABRICATION RESOURCE 1

1-Trim to length as per Dwg D2948 and DeburIdentify as D2948-5

2-Cut 3/4" x 3/4" square tubing as per Dwg D2948
Identify properly as D2948-1/-3/-7/-9

3-Remove all Markings From Material.

4-Weld as per Dwg D2948 and QSI 004. Debur as required.

A/R SS Rod Batch: M101134

PD 06-11-15 (1)

10.0	QC5/9	WELD INSPECTION
------	-------	-----------------



Comment: WELD INSPECTION

PD 06/11/16 (1)






Date: Thursday, 11/24/2005 8:09:58 AM
User: Linda Lacelle

Process Sheet

Customer: CU-DAR001 Dart Helicopters Services

Drawing Name: 407 BASKET BASE ASSEMBLY

Job Number: 21174A

Part Number: D2948041

Job Number:



Seq. #:

Machine Or Operation:

Description:

11.0

POWDER COATING

POWDER COATING



Comment: POWDER COATING

Powder Coat White Gloss (Ref: 4.3.5.1) as per OSI 00543

FC 06/12/05 ①

12.0

QC3

INSPECT POWDER COAT/CHEMICAL CONVERSION



Comment: INSPECT POWDER COAT/CHEMICAL CONVERSION

ml 06/12/06

13.0

PACKAGING 1

PACKAGING RESOURCE #1



Comment: PACKAGING RESOURCE #1

Identify and Stock

Location: GA

ml 06/12/06

14.0

DC

DOCUMENT CONTROL



Comment: DOCUMENT CONTROL

Inspection Level 21

① 06/12/07

Job Completion



u 06.12.07








NO. 74AWS D17.1.2001
QUALIFICATION TEST RECORDName Pat Duval
Joint Welding Procedure Tig
Part number and Job number 2952041 / B21174 B

TEST WELDS REQUIRED

BASE METAL Alum WELDING PROCESS Tig
Penetration Complete ☐ Partial ☐ Single Weld ☒ Double Weld ☐
Current AC ☐ DC ☐ Backing YES ☐ NO ☒


	Position	Vertical	Down <input type="checkbox"/>	Up <input type="checkbox"/>
Sheet Groove	1G <input type="checkbox"/>	2G <input type="checkbox"/>	3G <input type="checkbox"/>	4G <input type="checkbox"/>
Tube Groove	1G <input type="checkbox"/>	2G <input type="checkbox"/>	5G <input type="checkbox"/>	6G <input type="checkbox"/>
Sheet Fillet	1F <input type="checkbox"/>	2F <input type="checkbox"/>	3F <input type="checkbox"/>	4F <input type="checkbox"/>
Tube Fillet	1F <input type="checkbox"/>	2F <input type="checkbox"/>	4F <input type="checkbox"/>	5F <input type="checkbox"/>

Crossbolt Spacer Welded into Skidtube

TEST RESULTS

Visual Pass ☒ Fail ☐
Penetration Pass ☒ Fail ☐
Crossbolt Spacer Pass ☒ Fail ☐

The above named individual is qualified in accordance with AWS D17.1.2001 to weld

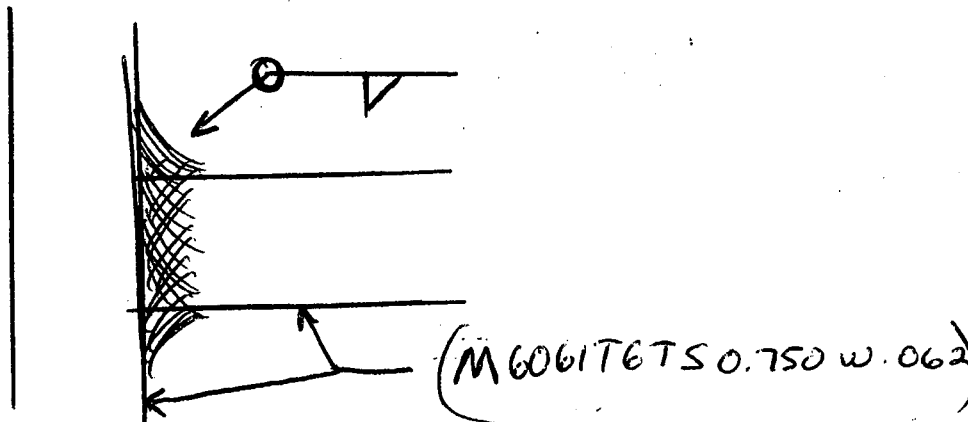Date of Test Coupon 06/11/08 Qualifier David Duval

Job Costing Report

Art Aerospace Ltd.
Hawkesbury

Nov 08, 2005
10:05 am

Subs?

Work Order No : 0021174
Project Name : D407-663-011
Project For : WK435
Work Order Type : Main
Main WO Number :
House Part Number : *D407-663-011
Description : Heli-Utility-Basket
Manufactured : Yes
Amount Req'd : 1
Amount Done : 0
Start Date : 07-01-04
Est Finish Date : 08-26-04
Act Finish Date :
Drawings Req'd : No
Ok for Approval :
Approval Rec'd :

Department Code:
Burden Flags : NNNNNNN
WO Status : Open
Invoice State : Not Invoiced
Invoice Date :
Invoice Number :
Invoice Amount : 0.00
Order Entry No :
OE Value : 0.00
Est Margin : 0.000%
Actual Margin : 0.000%
\$0 Posted to Finished Goods

	Estimated	Actual	Var. %	Posted	To Post
Material Cost :	0.00	0.00	0.00	0.00	0.00
Engineering Hours :	0.00	0.00	0.00		
Engineering Cost :	0.00	0.00	0.00	0.00	0.00
Production Hours :	0.00	1.75	100.00		
Production Cost :	0.00	32.04	100.00	0.00	32.04
Packaging Hours :	0.00	0.00	0.00		
Packaging Cost :	0.00	0.00	0.00	0.00	0.00
OverHead Hours :	0.00	0.00	0.00		
OverHead Cost :	0.00	0.00	0.00	0.00	0.00
CNC Hours :	0.00	0.00	0.00		
CNC :	0.00	0.00	0.00	0.00	0.00
Misc. Hours :	0.00	0.00	0.00		
Misc. :	0.00	0.00	0.00	0.00	0.00
Burden :	0.00	0.00	0.00		
Total Cost :	0.00	32.04	100.00		
Margin :	0.000	0.000			
Selling Cost :	0.00	32.04			

	Estimated	Actual
Labour Hrs/Amount Done :	0.00	0.00
Profits/(Loss) :	0.00	(-32.04)

35

DART AEROSPACE LTD	Work Order:	21174
Description: 407 Basket Base	Part Number:	D2948-041
Dwg: D2948 Rev. B	Qty:	1
Page 1 of 1		

Step	Location	Procedure	By	Date	Qty																				
1	DC	Issue Traveler	JP	04.07.05	1																				
2	LG	Cut (2) D2948-5, 3/4" x 3/4" square tubing as per Dwg D2948 Material: 304/316 SS tube 0.049" wall ^{120"} (M304TS0.750W.049) Identify for D2948-5 Batch: <u>B15357</u>	JP	05-9-27	1																				
3	LG	Form D2948-5 as per Dwg D2948 using CNC bending program 407BASB and Folio FT019	JP	05-9-27	1																				
4	WS	Trim to length as per Dwg D2948 and Deburr Identify as D2948-5																							
5	WS	Cut 3/4" x 3/4" square tubing as per Dwg D2948 Material: 304/316 SS tube 0.049" wall (M304TS0.750W.049) Identify properly as D2948-1/-3/-7/-9 Batch: _____																							
6	WS	Drill holes in D2948-3/-7 as per Dwg D2948. Deburr as required.																							
7	KP	Weld as per Dwg D2948 and QSI 004. Deburr as required. Pick: <table><tr><th>Qty</th><th>Part Number</th><th>Description</th><th>Batch</th></tr><tr><td>1</td><td>D2327-3</td><td>Spacer</td><td>_____</td></tr><tr><td>2</td><td>D2581</td><td>Mounting Bracket</td><td>_____</td></tr><tr><td>4</td><td>D2954</td><td>Mounting Plate</td><td>_____</td></tr><tr><td>32sf</td><td>M304EX0.75-16F</td><td>SS Expanded Metal</td><td>_____</td></tr></table>	Qty	Part Number	Description	Batch	1	D2327-3	Spacer	_____	2	D2581	Mounting Bracket	_____	4	D2954	Mounting Plate	_____	32sf	M304EX0.75-16F	SS Expanded Metal	_____			
Qty	Part Number	Description	Batch																						
1	D2327-3	Spacer	_____																						
2	D2581	Mounting Bracket	_____																						
4	D2954	Mounting Plate	_____																						
32sf	M304EX0.75-16F	SS Expanded Metal	_____																						
8	QC9/6	Inspect welding and dimensions																							
9	WS	Go to traveler D407-663-011 for Finishing																							

Rev	Date	Change	Revised By	Approved
A	00.03.22	New Issue	EC	
B	00.08.09	New dwg rev (mpp2078)	EC	
C	00.11.21	Added D2948-5 to pick list	EC	
D	03.11.26	Reformat; Incorporated D2948-5	KJ/RF	

RELEASED
04.01.09

Work Order		WORK ORDER CHANGES					
DATE	STEP	PROCEDURE CHANGE	By	Date	Qty	Approval Manuf / Design Mgr	Approval QC Inspector
05-9-27	1	Please add in 120"	DP	05-9-27			

NCR		WORK ORDER NON-CONFORMANCE						
DATE	STEP	Description of NC section A	Corrective Action Section B		Sign & Date	Verification Section C	Approval Design Mgr	Approval QC Inspector
			Initial					

PAR#: _____ Fault Category: _____ DQA: _____ Date: _____

NOTE: Date & initial all entries
H:\Admin-QA\ISO\forms\w\oncB.doc

QA: N/C Closed: _____ Date: _____

35

DART AEROSPACE LTD	Work Order:	21174
Description: 407 Basket Lid	Part Number:	D2952-041
Dwg: D2952 Rev. B	Qty:	
Page 1 of 1		

Step	Location	Procedure	By	Date	Qty																				
1	DC	Issue Traveler	21	04.07.05	1																				
2	WS	Cut 3/4" x 3/4" square tubing as per Dwg D2952 Material: 6061-T6 (QQ-A-200/8 or QQ-A-225/8) 0.062" wall (M6061T6TS0.750W.062) Identify as D2952-1/-3/-5/-7/-9 Batch: 21557																							
3	WS	Cut D2952-11 corner gussets as per Dwg D2952 Material: 5052-H32/H34 (QQ-A-250/11 or QQ-A-250/8) 0.080" (M5052H32S.080) Batch: _____ Identify as D2952-11																							
4	WS	Drill holes in D2952-3 as per Dwg D2952. Deburr.																							
5	WS	Weld as per Dwg D2952 as per QSI 004. Deburr as required. Pick: <table><tr><th>Qty</th><th>Part Number</th><th>Description</th><th>Batch</th></tr><tr><td>2</td><td>D2953-077</td><td>Spacer</td><td>_____</td></tr><tr><td>1</td><td>D2953-175</td><td>Spacer</td><td>_____</td></tr><tr><td>6</td><td>D2957</td><td>Mounting Plate</td><td>_____</td></tr><tr><td>15sf</td><td>M1100H14ES-3/4x.051F</td><td>Mesh</td><td>_____</td></tr></table>	Qty	Part Number	Description	Batch	2	D2953-077	Spacer	_____	1	D2953-175	Spacer	_____	6	D2957	Mounting Plate	_____	15sf	M1100H14ES-3/4x.051F	Mesh	_____			
Qty	Part Number	Description	Batch																						
2	D2953-077	Spacer	_____																						
1	D2953-175	Spacer	_____																						
6	D2957	Mounting Plate	_____																						
15sf	M1100H14ES-3/4x.051F	Mesh	_____																						
6	QC9/6	Inspect welding and dimensions																							
7	FP	Chemical Conversion Coat as per QSI 005 4.1																							
8	QC3	Inspect Conversion Coat																							
9	GA	Assemble Label Plate as per Dwg D2952 Pick: <table><tr><th>Qty</th><th>Part Number</th><th>Description</th><th>Batch</th></tr><tr><td>1</td><td>D2983</td><td>Label Plate</td><td>_____</td></tr><tr><td>34</td><td>MS20600AD4W2</td><td>Rivet</td><td>_____</td></tr></table>	Qty	Part Number	Description	Batch	1	D2983	Label Plate	_____	34	MS20600AD4W2	Rivet	_____											
Qty	Part Number	Description	Batch																						
1	D2983	Label Plate	_____																						
34	MS20600AD4W2	Rivet	_____																						
10	QC5	Inspect work to Step 9																							
11	GA	Go to traveler D407-663-011 for Finishing																							

Rev	Date	Change	Revised By	Approved
A	00.03.22	New Issue	EC	
B	00.07.12	Up dated Dwg rev.B	EC	
C	03.11.26	Reformat	KJ/RF	

RELEASED
04.01.09

Work Order:		WORK ORDER CHANGES					
DATE	STEP	PROCEDURE CHANGE	By	Date	Qty	Approval Manuf / Design Mgr	Approval QC Inspector
05/9/27		Replace old with new 1.20"	ASB				

NCR		WORK ORDER NON-CONFORMANCE						
DATE	STEP	Description of NC section A	Corrective Action Section B		Sign & Date	Verification Section C	Approval Design Mgr	Approval QC Inspector
			Initial					

PAR#: _____ Fault Category: _____ DQA: _____ Date: _____

QA: N/C Closed: _____ Date: _____

RELEASED
00.07.18

SEE DETAIL B

175

ENTER
ASKET

D2952-3

D2953-175 (REF)
SEE DETAIL A

ENLARGE $\phi 0.323$
TO $\phi 0.375$ AND
WELD D2953-077
EQUAL SPACE
BOTH SIDES

D2957 (REF)

TYP

DETAIL D

SHOP COPY

5 (TYP) RETURN TO
ENGINEERING

UNCONTROLLED COPY
SUBJECT TO AMENDMENT
WITHOUT NOTICE

WORK ORDER

NO. 21174

1.25 ± 0.03
0.00

DETAIL E

D2957 (REF)

6.00

DRILL $\phi 0.375$ HOLE
AND INSTALL D2953-175
SEE DETAIL A

MS20600AD4W2
RIVETS

MESH

D2983
LABEL PLATE

$R0.13 \pm 0.03$

0.25

SECTION F-F

3

D2952-11 GUSSET
(4 PLACES)

0.38 (TYP)

5

TYP

TYP

DETAIL B

WELD ALL JOINTS
AS SHOWN

45°

	DESCRIPTION	LENGTH A	LENGTH B
041	BASKET LID ASSEMBLY	N/A	N/A
1	FRAME MEMBER	N/A	84.00
3	FRAME MEMBER	N/A	23.50
5	FRAME MEMBER	22.00	N/A
7	FRAME MEMBER	15.88	N/A
9	FRAME MEMBER	24.25	N/A
11	GUSSET	N/A	N/A
175	SPACER	N/A	N/A
077	SPACER	N/A	N/A
	MOUNTING PLATE	N/A	N/A
	LABEL PLATE	N/A	N/A
	MS20600AD4W2 RIVETS	N/A	N/A

NOTES:

- 1) FRAME MATERIAL: 6061-T6, 3/4 x 3/4 x 0.063
- 2) MESH MATERIAL: 5005-H34 OR 3003-H14
- 3) GUSSET MATERIAL: 6061-T6 (QQ-A-250/11 (QQ-A-250/8) (3.00 x 3.00) 0.080 THICK
- 4) WELD PER DART QSI 004
- 5) GRIND 0.063 MAX x 45° CHAMFER BEFORE
- 6) GRIND WELDS FLUSH ON TOP SIDE FOR LABEL WELDS (4 PLS) BOTTOM SIDE FOR GUSSET
- 7) TRANSFER D2983 LABEL PLATE HOLES USING D2983 ONTO FRAME USING MS20600AD4W2
- 8) FINISH: CHEMICAL CONVERSION COAT PER DART POWDER COAT WHITE (REF. 4.3.5.1) PER DART
- 9) TOLERANCES ARE PER DART QSI 018 UNLESS

00.07.06

CHANGE FROM SHEET TO MESH;
ADD D2952-7/-9/-11

00.01.14

NEW ISSUE

DRAWN BY

RF

APPROVED

RF

DART

DART AEROSPACE LTD.
HAWKESBURY, ONTARIO, CANADA

DRAWING NO.

D2952

REV. B

SHEET 1 OF 1

TITLE



BASKET LID ASSEMBLY

SCALE




NTS

COPY ISSUED


RELEASED
00.07.18

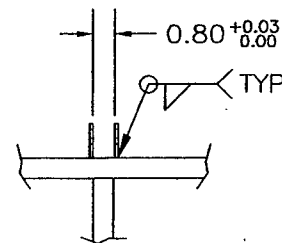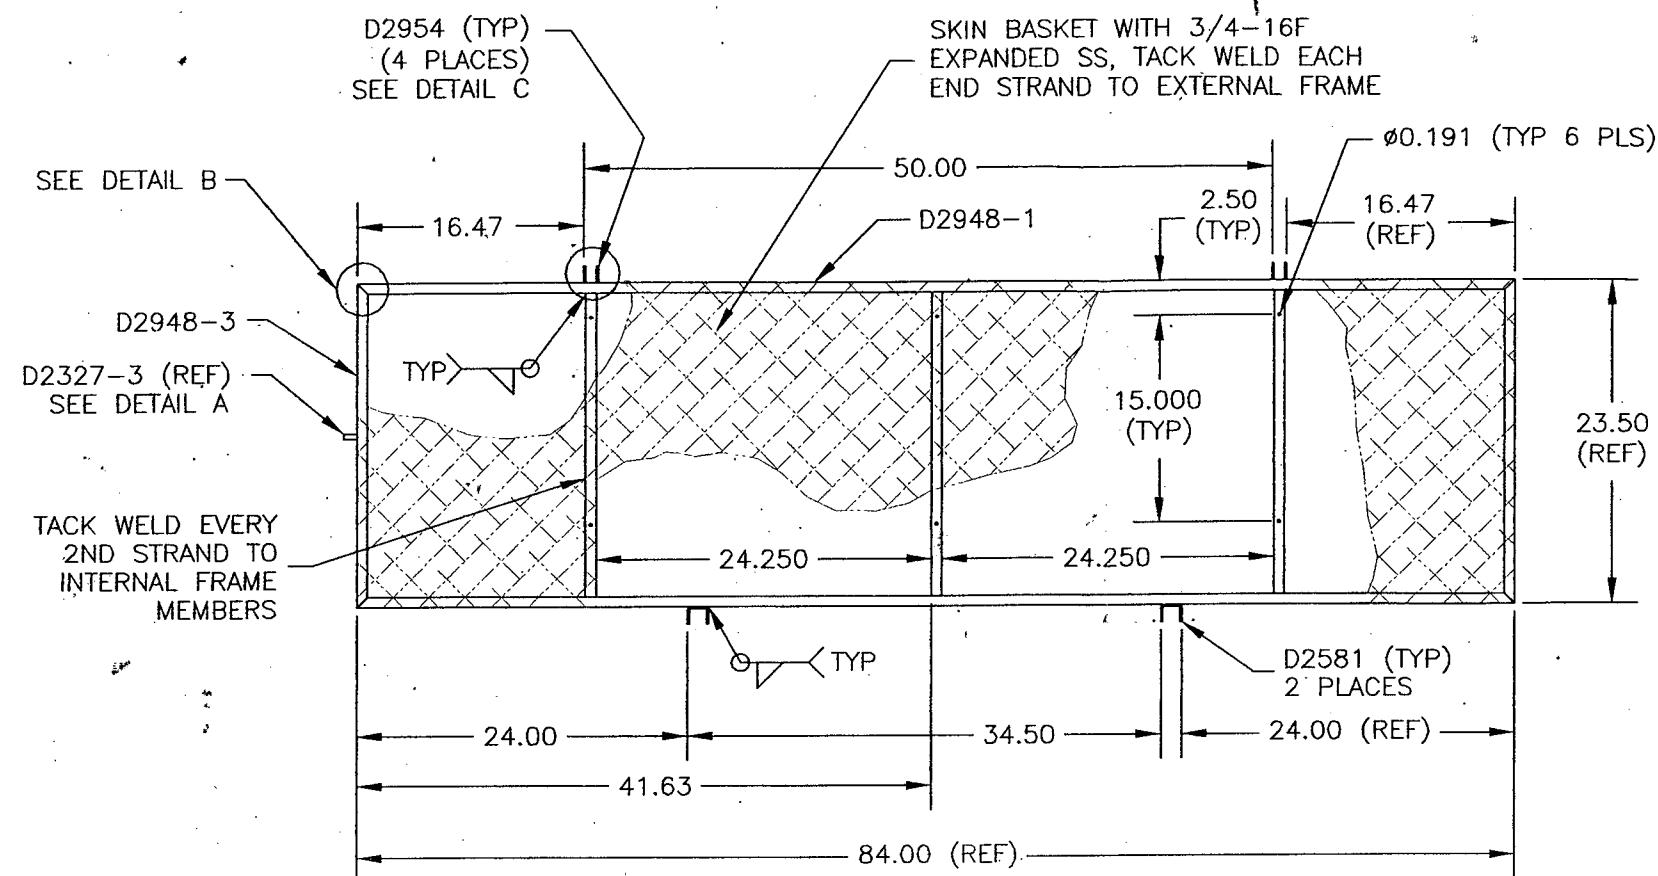

DETAIL C

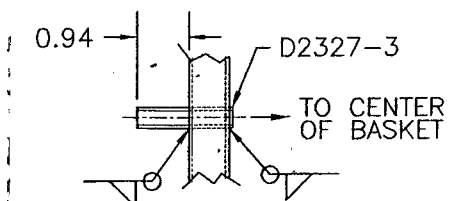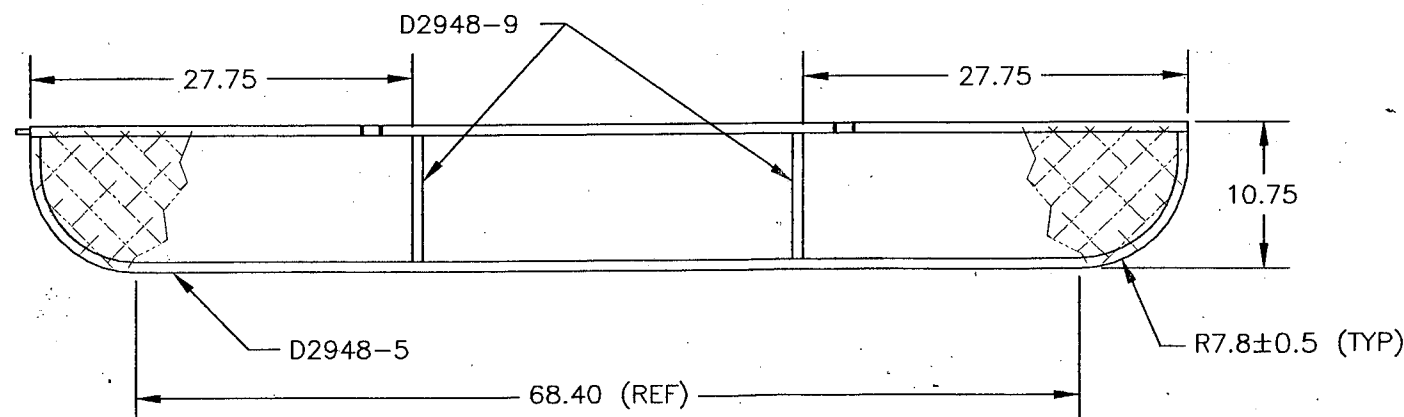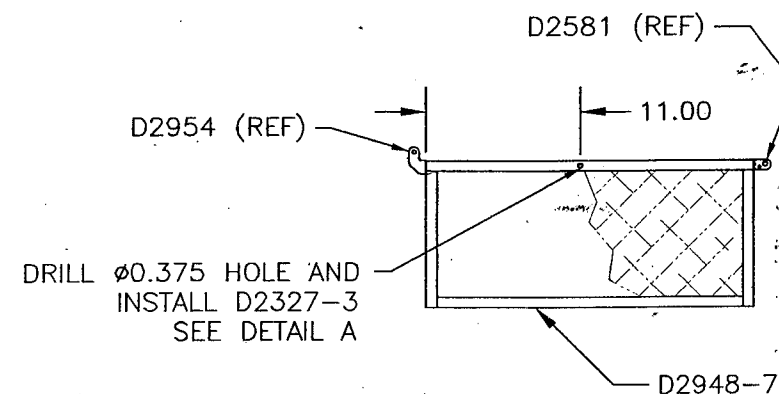


DETAIL A
SPACER INSTALLATION

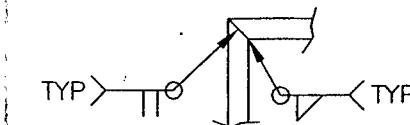

DETAIL B
WELD ALL JOINTS
AS SHOWN

SHOP COPY
RETURN TO
ENGINEERING
UNCONTROLLED COPY
SUBJECT TO AMENDMENT
WITHOUT NOTICE
WORK ORDER

NO. 21174

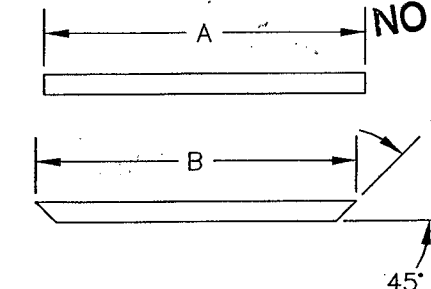

QTY	PART NUMBER	DESCRIPTION	LENGTH A	LENGTH B
-041				
X	D2948-041	BASKET ASSEMBLY	N/A	N/A
2	D2948-1	FRAME MEMBER	N/A	84.00
2	D2948-3	FRAME MEMBER	N/A	23.50
2	D2948-5	FRAME MEMBER	95.97	N/A
3	D2948-7	FRAME MEMBER	22.00	N/A
4	D2948-9	FRAME MEMBER	9.25	N/A
1	D2327-3	SPACER	N/A	N/A
2	D2581	MTG BRACKET	N/A	N/A
4	D2954	MOUNTING PLATE	N/A	N/A

FRAME MATERIAL: AISI 304/316 SS, 3/4 x 3/4 x 0.049 WALL SQUARE TUBING
MESH MATERIAL: 3/4-16F EXPANDED SS
FINISH: POWDER COAT WHITE (REF. 4.3.5.2) PER DART QSI 005 4.3
WELD PER DART QSI 004
TOLERANCES ARE PER DART QSI 018 UNLESS OTHERWISE NOTED

COPYRIGHT © 2000 BY DART AEROSPACE LTD.

THIS DOCUMENT IS PRIVATE AND CONFIDENTIAL
AND IS SUPPLIED ON THE EXPRESS CONDITION
THAT IT IS NOT TO BE USED FOR ANY PURPOSE
OR COPIED OR COMMUNICATED TO ANY OTHER
PERSON WITHOUT WRITTEN PERMISSION FROM
DART AEROSPACE LTD.

B	00.07.17	ADD Ø0.191; R7.8 WAS R6.8
A	00.01.12	NEW ISSUE
DESIGN	RF	DRAWN BY
CHECKED	RF	APPROVED
DATE	00.07.17	TITLE
		BASKET BASE ASSEMBLY

DART DART AEROSPACE LTD.
HAWKESBURY, ONTARIO, CANADA

DRAWING NO. D2948
REV. B
SHEET 1 OF 1
SCALE NTS

14.17 65.55

